


FORCEMAIN REROUTING - PLAN VIEW
SEE GRAY/NIVEN/GOODMAN PROFILE SHEET 34A

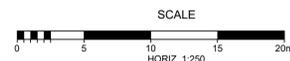


ORIENTATION

PLAN ONLY (APPROXIMATE)

CAUTION: DO NOT SCALE DRAWINGS.
THIS REPRODUCTION MAY BE AT A SIZE DIFFERENT THAN ORIGINALLY DRAWN. EXP ASSUMES NO RESPONSIBILITY FOR INCORRECT SCALING, UNAUTHORIZED REPRODUCTION OR REUSE IS STRICTLY PROHIBITED. NOT PUBLISHED - ALL RIGHTS RESERVED. EXP EXPRESSLY DISCLAIMS RESPONSIBILITY ARISING FROM UNAUTHORIZED USE OF THESE DRAWINGS AND NOTES. AUTHORIZATION MUST BE IN WRITING.

© exp, 2020

GENERAL NOTES:
1. ALL DIMENSIONS ARE IN METERS (m) UNLESS NOTED OTHERWISE.

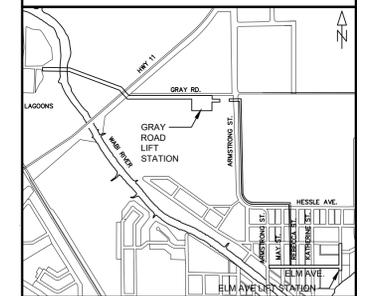

No.	DATE	REVISION	BY
4	4/6/2020	AS CONSTRUCTED	NJD
3	1/12/17	RE-ISSUED FOR CONSTRUCTION	NJD
2	26/9/17	ISSUED FOR CONSTRUCTION	MAL
1	10/8/17	ISSUED FOR REVIEW	MAL

CLIENT
THE CORPORATION OF THE CITY OF TEMISKAMING SHORES

PROJECT TITLE
TEMISKAMING SHORES INFRASTRUCTURE UPGRADES - PHASE 1

PROJECT No. **NWL-01601029**

DRAWING TITLE
NEW INLET STRUCTURE

DRAWN	SCALE
BRP	AS INDICATED
CHECKED	PLAN No.
MAL/NJD	016-1085
DRAWING No.	SHEET No.
DET5	34D

exp Services Inc.
1-705-647-4311 | F: 1-705-647-3111
9 Wellington St.
New Liskeard, ON P0J 1P0
Canada
www.exp.com

482023 3445 2/4 EXP SERVICES INC. 1000 WINDY HILL RD. UNIT 100 WINDY HILL, ONTARIO L0R 1A0 CANADA TEL: 705-647-4311 FAX: 705-647-3111